

STATE ENGINEER  
Salem, Oregon

**LANE**  
7908

# Well Record


STATE WELL NO. 16/LW-11H (1)  
COUNTY Lane  
APPLICATION NO. GR-566

OWNER: Hazel Melpass MAILING ADDRESS: Rt. 1

LOCATION OF WELL: Owner's No. #1 CITY AND STATE: Harrisburg, Ore.

SE  $\frac{1}{4}$  NE  $\frac{1}{4}$  Sec. 11 T. 16 S., R. 4 W., W.M.

Bearing and distance from section or subdivision corner S. 55° 18' E. 44.77 ch. from S.W. cor.  
John Ingram DIC #56

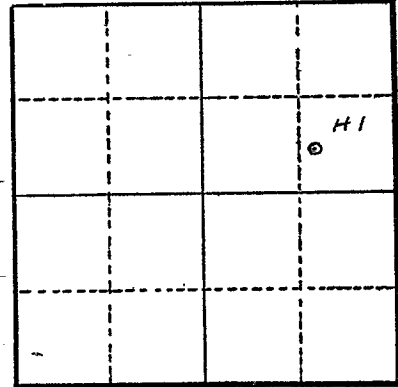

Section 11

Altitude at well 340

TYPE OF WELL: driven Date Constructed June 17, '52

Depth drilled 23 Depth cased \_\_\_\_\_

CASING RECORD:  
4 inch

FINISH:

AQUIFERS:

WATER LEVEL:  
14 ft.

PUMPING EQUIPMENT: Type Fairbanks Morse H.P. 20  
Capacity 475 G.P.M.

WELL TESTS:  
Drawdown \_\_\_\_\_ ft. after \_\_\_\_\_ hours \_\_\_\_\_ G.P.M.  
Drawdown \_\_\_\_\_ ft. after \_\_\_\_\_ hours \_\_\_\_\_ G.P.M.

USE OF WATER irrigation - 34.8 Ac. Temp. \_\_\_\_\_ °F. \_\_\_\_\_, 19\_\_\_\_

SOURCE OF INFORMATION GR-566  
DRILLER or DIGGER Mark Christinsen, Eugene, Ore

ADDITIONAL DATA:  
Log -- Water Level Measurements \_\_\_\_\_ Chemical Analysis \_\_\_\_\_ Aquifer Test \_\_\_\_\_

REMARKS: