

STATE ENGINEER  
Salem, Oregon

LANE  
7109

# Well Record

STATE WELL NO. 16/LW-11J (1)  
COUNTY Lane  
APPLICATION NO. GR-408

OWNER: D. J. Calvert


MAILING ADDRESS: Rt. 2, Box 449

LOCATION OF WELL: Owner's No. #1

CITY AND STATE: Eugene, Ore.

NE 1/4 SE 1/4 Sec. 11 T. 16 N S. R. 4 W., W.M.

Bearing and distance from section or subdivision  
corner 1693 ft. N. & 117 ft. W. from S.E. Cor.  
Sec. 11

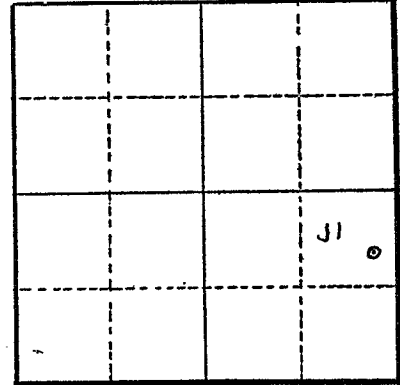

Section 11

Altitude at well 345

TYPE OF WELL: driven Date Constructed 1942

Depth drilled 25 Depth cased 24

CASING RECORD:

4 inch

FINISH:

AQUIFERS:

WATER LEVEL:

20

PUMPING EQUIPMENT: Type Fairbanks Morse H.P. 10-2  
Capacity 250 G.P.M.

WELL TESTS:

Drawdown \_\_\_\_\_ ft. after \_\_\_\_\_ hours \_\_\_\_\_ G.P.M.  
Drawdown \_\_\_\_\_ ft. after \_\_\_\_\_ hours \_\_\_\_\_ G.P.M.

USE OF WATER irrigation - 18 Temp. \_\_\_\_\_ °F. \_\_\_\_\_, 19

SOURCE OF INFORMATION GR-408

DRILLER or DIGGER --

ADDITIONAL DATA:

Log No Water Level Measurements \_\_\_\_\_ Chemical Analysis \_\_\_\_\_ Aquifer Test \_\_\_\_\_

REMARKS: