

STATE ENGINEER  
Salem, Oregon

LANE  
7910

# Well Record

STATE WELL NO. 16/4W-11J(2)  
COUNTY Lane  
APPLICATION NO. GR-1358

GR- 1313

OWNER: Waldemar Christensen


MAILING ADDRESS: Rt. 2, Box 449C

LOCATION OF WELL: Owner's No.

CITY AND STATE: Eugene, Oregon

NE 1/4 SE 1/4 Sec. 11 T. 16 S., R. 4 W., W.M.

Bearing and distance from section or subdivision  
corner 2256' N28°39'W. from the SE cor. Sec. 11.

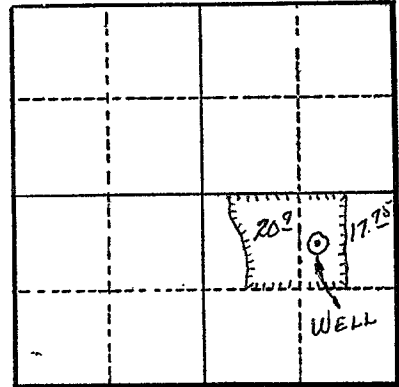

Section 11

Altitude at well 340 ft.

TYPE OF WELL: Drilled Date Constructed 1941

Depth drilled 30 ft. Depth cased 30 ft.

### CASING RECORD:

4 inch?

### FINISH:

Perforated: slotted from 20 to 30 ft.

### AQUIFERS:

### WATER LEVEL:

10 ft.

PUMPING EQUIPMENT: Type Cent. H.P. 15

Capacity 350 G.P.M.

### WELL TESTS:

Drawdown 3 ft. after 350 hours G.P.M.

Drawdown ft. after hours G.P.M.

USE OF WATER Irrigation Temp. °F., 19

SOURCE OF INFORMATION G. R. Record

DRILLER or DIGGER

### ADDITIONAL DATA:

Log Water Level Measurements Chemical Analysis Aquifer Test

### REMARKS:

Log: Top soil 0 to 6 ft.  
Gravel 6 to 30 ft.

Irrigation of 38.65 acres.