

STATE ENGINEER
Salem, Oregon

LANE Well Record
7911 GR-1353

STATE WELL NO. 16/4W-111.1)
COUNTY Lane
APPLICATION NO. GR-1397

OWNER: Ison Cox


MAILING ADDRESS: Rt. 1

LOCATION OF WELL: Owner's No. #1

CITY AND STATE: Harrisburg, Oregon

NE 1/4 SW 1/4 Sec. 11 T. 16 S., R. 4 W., W.M.

Bearing and distance from section or subdivision corner 677' S. & 155' W. from Center of Sec. 11

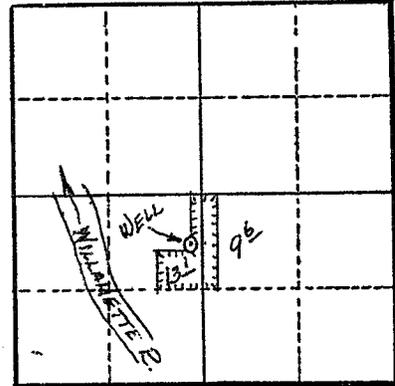

Section 11

Altitude at well 340 ft.

TYPE OF WELL: Driven Date Constructed 1945

Depth drilled 20 ft. Depth cased 20 ft.

CASING RECORD:

2 - 4 inch pipes connected

FINISH:

Slot perforated from 14 to 20 ft.

AQUIFERS:

WATER LEVEL:

9 ft.

PUMPING EQUIPMENT: Type F. M. 4 in. Cent. H.P. 25

Capacity 420 G.P.M.

WELL TESTS:

Drawdown ft. after hours G.P.M.

Drawdown ft. after hours G.P.M.

USE OF WATER Irrigation Temp. °F. 19

SOURCE OF INFORMATION G. R. Record

DRILLER or DIGGER

ADDITIONAL DATA:

Log N.A. Water Level Measurements Chemical Analysis Aquifer Test

REMARKS:

Irrigation of 22.7 acres.