

STATE ENGINEER
Salem, Oregon

Well Record

STATE WELL NO. 16/4W-111(2)
COUNTY Lane
APPLICATION NO. GR-1399

LANE
7912

GR- 1355

OWNER: Isom Cook


MAILING ADDRESS: Rt. 1

LOCATION OF WELL: Owner's No. #3

CITY AND STATE: Harrisburg, Oregon

NE 1/4 SW 1/4 Sec. 11 T. 16 S., R. 4 W., W.M.

Bearing and distance from section or subdivision corner 310' S. & 465' W. of Center Sec. 11

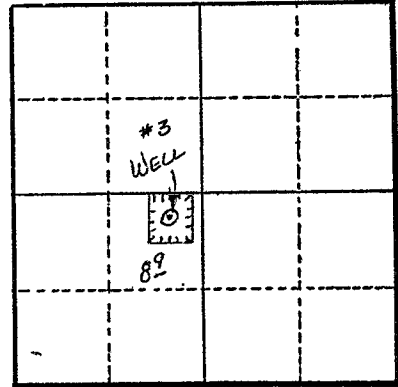

Altitude at well 340 ft.

TYPE OF WELL: Driven Date Constructed 1951

Depth drilled 20 ft. Depth cased 20 ft.

Section 11

CASING RECORD:

4 inch

FINISH:

Slot perforated from 14 to 20 ft.

AQUIFERS:

WATER LEVEL:

12 ft.

PUMPING EQUIPMENT: Type F. M. 2 in. Cent. H.P. 10

Capacity 200 G.P.M.

WELL TESTS:

Drawdown _____ ft. after _____ hours _____ G.P.M.

Drawdown _____ ft. after _____ hours _____ G.P.M.

USE OF WATER Irrigation Temp. _____ °F. _____, 19____

SOURCE OF INFORMATION G. R. Record

DRILLER or DIGGER _____

ADDITIONAL DATA:

Log N.A. Water Level Measurements _____ Chemical Analysis _____ Aquifer Test _____

REMARKS:

Irrigation of 8.9 acres.