

STATE ENGINEER
Salem, Oregon

LANE-ANE 7913
Well Record
GR- 1356


STATE WELL NO. 16/4W-111(3)
COUNTY Lane
APPLICATION NO. GR-1400

OWNER: Isom Cox MAILING ADDRESS: Rt. 1

LOCATION OF WELL: Owner's No. #4 CITY AND STATE: Harrisburg, Oregon

NE 1/4 SW 1/4 Sec. 11 T. 16 S., R. 4 W., W.M.

Bearing and distance from section or subdivision corner 743' S. & 1239' W. from Center of Sec. 11.

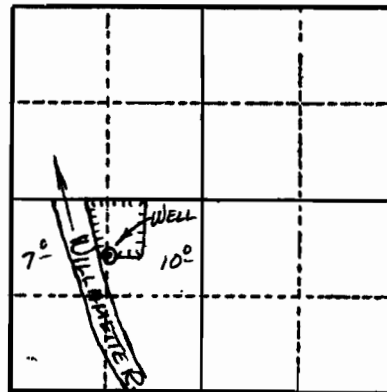

Section 11

Altitude at well 340 ft.

TYPE OF WELL: Driven Date Constructed 1952

Depth drilled 24 ft. Depth cased 24 ft.

CASING RECORD:

4 inch

FINISH:

Slot perforations from 18 to 24 ft.

AQUIFERS:

WATER LEVEL:

12 ft.

PUMPING EQUIPMENT: Type F. M. 2 in. Cent. H.P. 10

Capacity 200 G.P.M.

WELL TESTS:

Drawdown ft. after hours G.P.M.

Drawdown ft. after hours G.P.M.

USE OF WATER Irrigation Temp. °F., 19

SOURCE OF INFORMATION G. R. Record

DRILLER or DIGGER

ADDITIONAL DATA:

Log N.A. Water Level Measurements Chemical Analysis Aquifer Test

REMARKS:

Irrigation of 17 acres.