

STATE ENGINEER
Salem, Oregon

LANE
7914

Well Record

GR- 1622

STATE WELL NO. 16/W-11N
COUNTY Lane
APPLICATION NO. GR- 1671

OWNER: Rachel Swan Estate


MAILING ADDRESS: Rt. 2

LOCATION OF WELL: Owner's No.

CITY AND STATE: Junction City, Oregon

SW ^{XX} 1/4 SW ^{XX} 1/4 Sec. 11 T. 16 S., R. 4 W., W.M.

Bearing and distance from section or subdivision corner 1200' N. from SW cor. Sec. 11

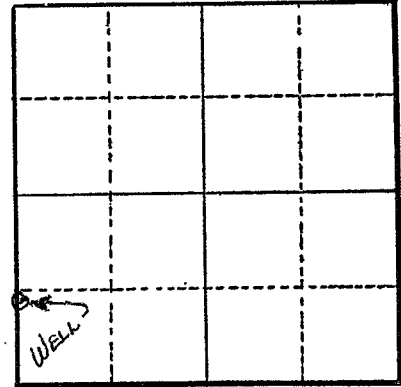

Section 11

Altitude at well

TYPE OF WELL: Driven Date Constructed 1942

Depth drilled 30' Depth cased 30'

CASING RECORD:

6"

FINISH:

AQUIFERS:

WATER LEVEL:

8'

PUMPING EQUIPMENT: Type Cornell Cent. H.P. 7 1/2
Capacity 250 G.P.M.

WELL TESTS:

Drawdown ft. after hours G.P.M.
Drawdown ft. after hours G.P.M.

USE OF WATER Irrigation Temp. °F. 19

SOURCE OF INFORMATION GR Record

DRILLER or DIGGER

ADDITIONAL DATA:

Log N.A. Water Level Measurements Chemical Analysis Aquifer Test

REMARKS:

Irrigation of 16 acres.