

STATE ENGINEER
Salem, Oregon

LANE
795

Well Record

GR- 1789


STATE WELL NO. 16/4W-11P
COUNTY Lane
APPLICATION NO. GR-1845

OWNER: John B. & Betty Jo Christensen
MAILING ADDRESS: Rt. 2, Box 407

LOCATION OF WELL: Owner's No. #A
CITY AND STATE: Eugene, Oregon

SE ^{XX} 1/4 SW ^{XX} 1/4 Sec. 11 T. 16 S., R. 4 W., W.M.

Bearing and distance from section or subdivision
corner N. 61° 32' W, 1883.9' from SE cor. of W 1/2 of
SE 1/4 of Section 11.

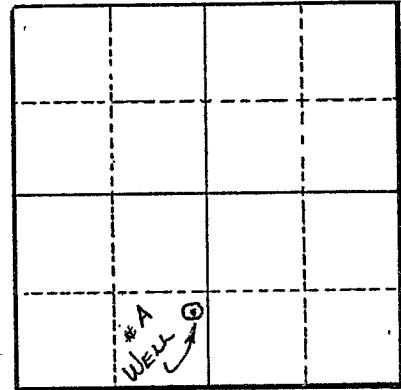

Section 11

Altitude at well 350'

TYPE OF WELL: Drilled Date Constructed 1940

Depth drilled 18' Depth cased 18'

CASING RECORD:

3 - 3" joined at surface to make one well

FINISH:

2" x 1/4" slot perforations from 12 to 18 ft.

AQUIFERS:

WATER LEVEL:

6'

PUMPING EQUIPMENT: Type F. M. 3" Cent. H.P. 15
Capacity 360 G.P.M.

WELL TESTS:

Drawdown ft. after hours G.P.M.
Drawdown ft. after hours G.P.M.

USE OF WATER Irrigation Temp. °F. 19

SOURCE OF INFORMATION GR Record

DRILLER or DIGGER

ADDITIONAL DATA:

Log N.A. Water Level Measurements Chemical Analysis Aquifer Test

REMARKS:

Irrigation of 8 acres.