

STATE ENGINEER
Salem, Oregon

LANE
7916

Well Record

GR- 1770

STATE WELL NO. 16/4W-110
COUNTY Lane
APPLICATION NO. GR- 1826

OWNER: James E. Detering


MAILING ADDRESS: Rt. 2, Box 448

LOCATION OF WELL: Owner's No. #1

CITY AND STATE: Eugene, Oregon

SW 1/4 SE 1/4 Sec. 11 T. 16 S., R. 4 W., W.M.

Bearing and distance from section or subdivision corner 450' N. & 1665' W. from SE cor. Sec. 11

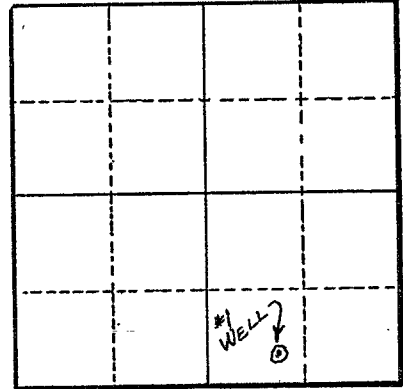

Section 11

Altitude at well 351'

TYPE OF WELL: Driven Date Constructed 1945

Depth drilled 22' Depth cased 22'

CASING RECORD:

2- 4" pipes

FINISH:

Bottom 4' perforated with 1/4" x 1 1/2" slots - 8 per ft.

AQUIFERS:

WATER LEVEL:

8' Est.

PUMPING EQUIPMENT: Type Berkeley Cent. 2 1/2 x 2 in. H.P. 15
Capacity 350 G.P.M.

WELL TESTS:

Drawdown ft. after hours G.P.M.
Drawdown ft. after hours G.P.M.

USE OF WATER Irrigation Temp. °F., 19

SOURCE OF INFORMATION GR Record

DRILLER or DIGGER

ADDITIONAL DATA:

Log N.A. Water Level Measurements Chemical Analysis Aquifer Test

REMARKS:

Irrigation of 10 acres.