

STATE ENGINEER  
Salem, Oregon

LANE  
7917

# Well Record

STATE WELL NO. 16/LW-110 (1)  
COUNTY Lane  
APPLICATION NO. GR-408

OWNER: D. J. Calvert


MAILING ADDRESS: Rt. #2, Box 449

LOCATION OF WELL: Owner's No. #4

CITY AND STATE: Eugene, Ore.

SW 1/4 SE 1/4 Sec. 11 T. 16 N S., R. 4 W., W.M.

Bearing and distance from section or subdivision  
corner 850 ft. N. & 1970 ft. W. from S.E. cor.  
sec. 11

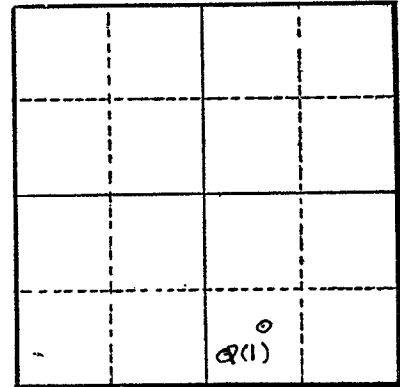

Section 11

Altitude at well 345

TYPE OF WELL: drilled Date Constructed 1942

Depth drilled 25 Depth cased 25

### CASING RECORD:

4 inch

### FINISH:

### AQUIFERS:

### WATER LEVEL:

PUMPING EQUIPMENT: Type Fairbanks Morse H.P. 10-2  
Capacity 250 G.P.M.

### WELL TESTS:

Drawdown \_\_\_\_\_ ft. after \_\_\_\_\_ hours \_\_\_\_\_ G.P.M.  
Drawdown \_\_\_\_\_ ft. after \_\_\_\_\_ hours \_\_\_\_\_ G.P.M.

USE OF WATER irrigation - 17 Temp. \_\_\_\_\_ °F. \_\_\_\_\_, 19

SOURCE OF INFORMATION GR-408

DRILLER or DIGGER ---

### ADDITIONAL DATA:

Log  No Water Level Measurements \_\_\_\_\_ Chemical Analysis \_\_\_\_\_ Aquifer Test \_\_\_\_\_

### REMARKS: