

STATE ENGINEER  
Salem, Oregon


LANE  
7918

# Well Record

STATE WELL NO. 16/4W-11R(1)  
COUNTY Lane  
APPLICATION NO. GR-408

OWNER: D. J. Calvert  
MAILING ADDRESS: Rt. 2, Box 449  
CITY AND STATE: Eugene, Oregon

LOCATION OF WELL: Owner's No. 2  
SE 1/4 SE 1/4 Sec. 11 T. 16 S., R. 4 W., W.M.

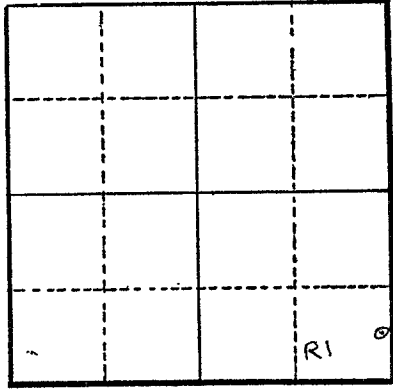

Bearing and distance from section or subdivision  
corner 518 ft. N. & 82 ft. W. from SE cor. Sec. 11

Altitude at well 345

TYPE OF WELL: driven Date Constructed 1936

Depth drilled 25 Depth cased 25

Section 11

CASING RECORD: 4 inch

FINISH:

AQUIFERS:

WATER LEVEL: 20

PUMPING EQUIPMENT: Type Fairbanks Morse H.P. 10-2  
Capacity 250 G.P.M.

WELL TESTS:  
Drawdown \_\_\_\_\_ ft. after \_\_\_\_\_ hours \_\_\_\_\_ G.P.M.  
Drawdown \_\_\_\_\_ ft. after \_\_\_\_\_ hours \_\_\_\_\_ G.P.M.

USE OF WATER irrigation 25 acres Temp. \_\_\_\_\_ °F., 19

SOURCE OF INFORMATION GR-408

DRILLER or DIGGER

ADDITIONAL DATA:  
Log No Water Level Measurements \_\_\_\_\_ Chemical Analysis \_\_\_\_\_ Aquifer Test \_\_\_\_\_

REMARKS: