

STATE ENGINEER  
Salem, Oregon

LANE  
7919

# Well Record

STATE WELL NO. 16/4W-11R(2)  
COUNTY Lane  
APPLICATION NO. GR-408

OWNER: D. J. Calvert MAILING ADDRESS: Rt. 2, Box 449

LOCATION OF WELL: Owner's No. 3 CITY AND STATE: Eugene, Oregon

SE 1/4 SE 1/4 Sec. 11 T. 16 S., R. 4 W., W.M.


Bearing and distance from section or subdivision  
corner 550' N. & 985' W. from SE cor. Sec. 11

Altitude at well 345

TYPE OF WELL: driven Date Constructed 1947

Depth drilled 25 Depth cased 25

CASING RECORD: 4 inch

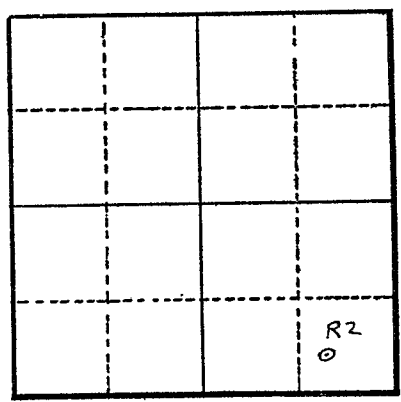

Section 11

FINISH:

AQUIFERS:

WATER LEVEL: 20

PUMPING EQUIPMENT: Type Fairbanks Morse H.P. 10-2  
Capacity 250 G.P.M.

WELL TESTS:  
Drawdown ..... ft. after ..... hours ..... G.P.M.  
Drawdown ..... ft. after ..... hours ..... G.P.M.

USE OF WATER irrigation 35 acres Temp. .... °F. ...., 19....

SOURCE OF INFORMATION GR-408

DRILLER or DIGGER .....  
ADDITIONAL DATA:  
Log No Water Level Measurements ..... Chemical Analysis ..... Aquifer Test .....

REMARKS: