

STATE ENGINEER  
Salem, Oregon

**LANE**  
7939

# Well Record

GR- 1148

STATE WELL NO. 16/4W-13G(1)  
COUNTY Lane  
APPLICATION NO. GR- 1187

OWNER: E. C. Tullar


MAILING ADDRESS: Rt. 2, Box 451

LOCATION OF WELL: Owner's No.

CITY AND STATE: Eugene, Oregon

NE 1/4 NW 1/4 Sec. 13 T. 16 S. R. 4 W., W.M.

Bearing and distance from section or subdivision corner 1559' S. 58°55' E. of NW cor. Sec. 13.

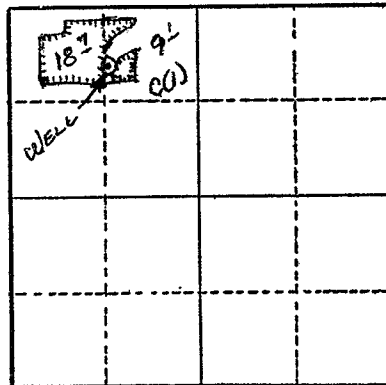

Section 13

Altitude at well 342 ft.

TYPE OF WELL: Dug Date Constructed 1942

Depth drilled 8 ft. Depth cased 8 ft.

### CASING RECORD:

19 in. Steel casing

### FINISH:

1/2 x 1 in. slot perforations spaced 6 in. apart from 6 1/2 to 8 ft.

### AQUIFERS:

### WATER LEVEL:

3 ft.

PUMPING EQUIPMENT: Type Berkeley Cent. H.P. 15  
Capacity 350 G.P.M.

WELL TESTS:  
Drawdown 7 ft. after hours 350 G.P.M.  
Drawdown ft. after hours G.P.M.

USE OF WATER Irrigation Temp. °F. 19

SOURCE OF INFORMATION G. R. Record

DRILLER or DIGGER Owner

ADDITIONAL DATA:  
Log Water Level Measurements Chemical Analysis Aquifer Test

### REMARKS:

Log: River gravel 0 to 8 ft.

Irrigation of 27.8 acres.