

STATE ENGINEER  
Salem, Oregon

**LANE**  
**7940**

# Well Record

GR- 1175

STATE WELL NO. 16/4W-13E(1)  
COUNTY Lane  
APPLICATION NO. GR- 1215

OWNER: George M. Seifert

MAILING ADDRESS: Rt. 2


LOCATION OF WELL: Owner's No. #2

CITY AND STATE: Eugene, Oregon

SW 1/4 NW 1/4 Sec. 13 T. 16 S., R. 4 W., W.M.

Bearing and distance from section or subdivision

corner S. 1625' & W. 1350' from N 1/4 cor. Sec. 13

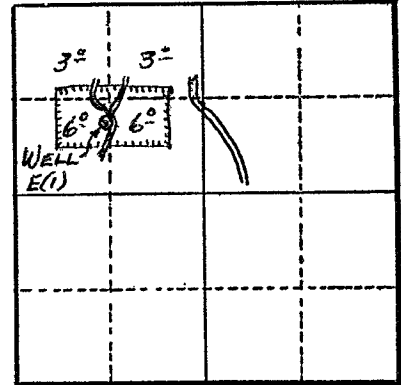

Section 13

Altitude at well 338 ±

TYPE OF WELL: Driven Date Constructed 1947

Depth drilled 18 ft. Depth cased 18 ft.

### CASING RECORD:

5 inch

### FINISH:

Perforated - slotted 1/2 x 3 in. (9 per ft.) from 15 to 18 ft.

### AQUIFERS:

### WATER LEVEL:

4 ft.

PUMPING EQUIPMENT: Type F. M. 4 x 3 in. H.P. 20

Capacity 500 G.P.M.

### WELL TESTS:

Drawdown 8 ft. after 500 hours 500 G.P.M.

Drawdown \_\_\_\_\_ ft. after \_\_\_\_\_ hours \_\_\_\_\_ G.P.M.

USE OF WATER Irrigation Temp. \_\_\_\_\_ °F., 19

SOURCE OF INFORMATION G. R. Record

DRILLER or DIGGER \_\_\_\_\_

### ADDITIONAL DATA:

Log N.A. Water Level Measurements \_\_\_\_\_ Chemical Analysis \_\_\_\_\_ Aquifer Test \_\_\_\_\_

### REMARKS:

Irrigation of 18 acres.