STATE ENGINEER
Salem, Oregon

LANE 7941

Well Record

GR- 1176

STATE WELL NO. 16/4W-13G(1)
COUNTY Lane
APPLICATION NO. GR- 1216

OWNER: George M. Seifert
MAILING ADDRESS: Rt. 2
CITY AND STATE: Eugene, Oregon

LOCATION OF WELL: Owner's No. #1

SW ¼ NE ¼ Sec. 13 T. 16 N. S., R. 4 W., W.M.

Bearing and distance from section or subdivision corner 1725' S. & 125' E. from N¼ cor. Sec. 13.

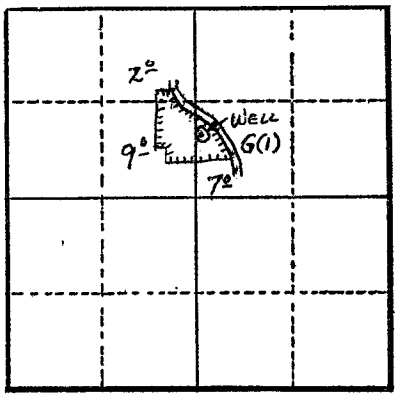

Section 13

Altitude at well 360 ft. ±

TYPE OF WELL: Driven Date Constructed 1926

Depth drilled 20 ft. Depth cased 20 ft.

CASING RECORD:
4 inch

FINISH:
Perforated - slotted ½ x 3 in. (6 per ft.) from 17 to 20 ft.

AQUIFERS:

WATER LEVEL:
4 - 8 ft.

PUMPING EQUIPMENT: Type F. M. 2 x 2½ in. H.P. 15
Capacity 225 G.P.M.

WELL TESTS:
Drawdown ft. after hours G.P.M.
Drawdown ft. after hours G.P.M.

USE OF WATER Irrigation Temp. °F., 19
SOURCE OF INFORMATION G. R. Record
DRILLER or DIGGER
ADDITIONAL DATA:
Log N.A. Water Level Measurements Chemical Analysis Aquifer Test

REMARKS:
Irrigation of 18 acres.

State Printing 89316