

STATE ENGINEER
Salem, Oregon

LANE
1942

Well Record

STATE WELL NO. 16/4W-13P(1&2)
COUNTY Lane
APPLICATION NO. GR-318

OWNER: Floyd Bell

MAILING ADDRESS:

Rt. 2, Box 457


LOCATION OF WELL: Owner's No. 1 & 2

CITY AND STATE:

Coburg - Harrisburg Road
Eugene, Oregon

SE 1/4 SW 1/4 Sec. 13 T. 16 N S, R. 4 W, W.M.

Bearing and distance from section or subdivision
corner S. 30° 44' E. 1365.8 ft. to SW cor. of
John Wilson DLC 55

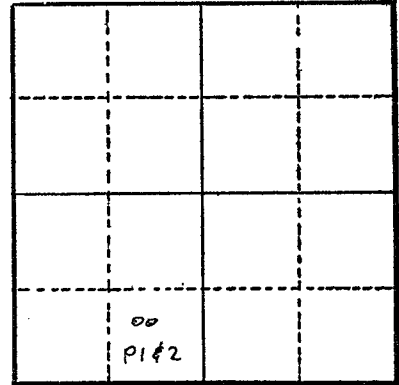

Altitude at well 350 ft. Interpolated

TYPE OF WELL: drilled Date Constructed May 1941

Depth drilled 24 Depth cased 20

Section 13

CASING RECORD: 4 - inch (pipe?) set from minus 4 to 24 ft.

FINISH: 1/2" x 6" slots are staggered. 8 slots per ft. from 18 to 24 ft.

AQUIFERS: Sand & gravel - 8 to 24 ft.

WATER LEVEL: 10 ft. below land surface

PUMPING EQUIPMENT: Type Fairbanks Morse H.P. 27 (gas)
Capacity 600 G.P.M.

WELL TESTS:
Drawdown 4 ft. after _____ hours pumping 600 G.P.M.
Drawdown _____ ft. after _____ hours _____ G.P.M.

USE OF WATER irrigation 53.15 ac. Temp. _____ °F., 19

SOURCE OF INFORMATION Reg. Statement GR-318

DRILLER or DIGGER _____

ADDITIONAL DATA:
Log Water Level Measurements _____ Chemical Analysis _____ Aquifer Test _____

REMARKS: Log:

Loam, river bottom	0 to 8 ft.	8" thick	Wells connected
Gravel & sand	8 to 16 ft.	8" thick	
Gravel, river	16 to 24 ft.	8" thick	