

STATE ENGINEER
Salem, Oregon

LANE Well Record
7953


STATE WELL NO. 16/4W-14A(1)
COUNTY Lane
APPLICATION NO. GR-102

OWNER: Edward A. Gent MAILING ADDRESS: 1170 Coburg Road

LOCATION OF WELL: Owner's No. 1 CITY AND STATE: Eugene, Oregon

NW $\frac{1}{4}$ NE $\frac{1}{4}$ Sec. 14 T. 16 S., R. 4 W., W.M.

Bearing and distance from section or subdivision corner 1100' W. & 650' S. from NE cor. Sec. 14

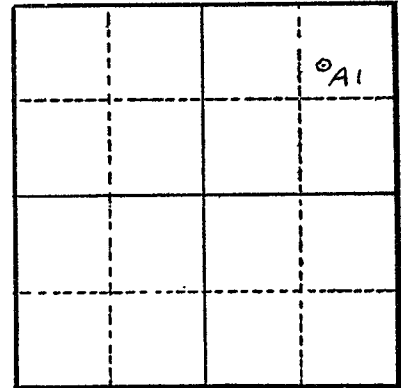

Altitude at well 350 ft. Interpolated

TYPE OF WELL: driven Date Constructed 4/15/46 or 6/1/31 old well
Depth drilled 20 Depth cased 20 Section 14

CASING RECORD: 2 - 2 in. steel pipes set 3 ft. apart, from 0 to 20 ft.

FINISH: Both casings perforated by 10 - 5/32 in. slots from 17 to 20 ft.

AQUIFERS: Sand and gravel from 10 to 20 ft.

WATER LEVEL: 10 ft. below land surface

PUMPING EQUIPMENT: Type Fairbanks Morse 2 in. Dir-con. H.P. _____
Capacity 200 G.P.M.

WELL TESTS:
Drawdown 5 ft. after _____ hours 200 G.P.M.
Drawdown _____ ft. after _____ hours _____ G.P.M.

USE OF WATER irrigation 16.65 acres Temp. _____ °F. _____, 19. _____
SOURCE OF INFORMATION Reg. Statement GR-102

DRILLER or DIGGER _____

ADDITIONAL DATA:
Log Water Level Measurements _____ Chemical Analysis _____ Aquifer Test _____

REMARKS: Log: Loam, sandy 0 - 10 ft.
Sand & gravel 10 - 20 ft.