

STATE ENGINEER  
Salem, Oregon

**LANE**  
7954

# Well Record

GR- 1771

STATE WELL NO. 16/4W-14A  
COUNTY Lane  
APPLICATION NO. GR- 1827

OWNER: James E. Detering


MAILING ADDRESS: Rt. 2, Box 448

LOCATION OF WELL: Owner's No. #2

CITY AND STATE: Eugene, Oregon

NE 1/4 NE 1/4 Sec. 14 T. 16 S. R. 4 W., W.M.

Bearing and distance from section or subdivision corner 650' S. & 750' W. from NE cor. Sec. 14

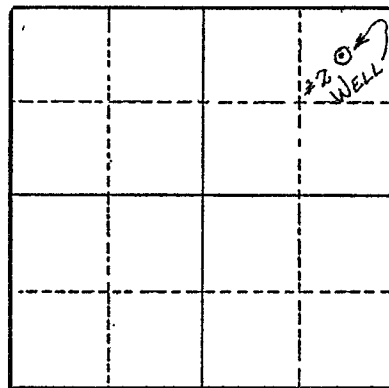

Section 14

Altitude at well 351'

TYPE OF WELL: Driven Date Constructed 1929

Depth drilled 19' Depth cased 19'

### CASING RECORD:

5"

### FINISH:

Perforated: 1/4" slots x 1 1/4" - 12 per ft.

### AQUIFERS:

Gravel

### WATER LEVEL:

12' Est.

PUMPING EQUIPMENT: Type Berkeley 2 1/2" x 2" Cent. H.P. 15  
Capacity 350 G.P.M.

### WELL TESTS:

Drawdown ..... ft. after ..... hours ..... G.P.M.

Drawdown ..... ft. after ..... hours ..... G.P.M.

USE OF WATER Irrigation Temp. °F. , 19

SOURCE OF INFORMATION GR Record

DRILLER or DIGGER

### ADDITIONAL DATA:

Log N.A. Water Level Measurements Chemical Analysis Aquifer Test

### REMARKS:

Mostly water bearing gravel below 12 ft.

Irrigation of 30 acres.