

STATE ENGINEER
Salem, Oregon

LANE
7155

Well Record

STATE WELL NO. 16/4W-14L
COUNTY LANE
APPLICATION NO. GR-2779

OWNER: E. B. Brown Jr.

MAILING
ADDRESS:

1370 Maple Dr.

LOCATION OF WELL: Owner's No.


CITY AND
STATE:

Junction City, Oregon

NE 1/4 SW 1/4 Sec. 14 T. 16 N. 4 E. S. R. 4 W., W.M.

Bearing and distance from section or subdivision

corner 2995 N. 47° 10' E.

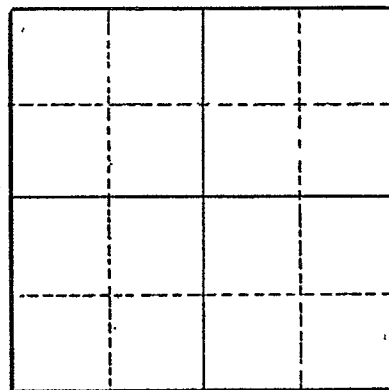

Altitude at well

TYPE OF WELL: driven Date Constructed 1947

Depth drilled 21 Depth cased 21

Section

CASING RECORD:

3-inch

FINISH:

3' of perforations size and number unknown

AQUIFERS:

Loam, sand and gravel

WATER LEVEL:

8-feet

PUMPING EQUIPMENT: Type Centrifugal H.P. 20
Capacity 125 G.P.M.

WELL TESTS:

Drawdown ft. after hours G.P.M.

Drawdown ft. after hours G.P.M.

USE OF WATER irrigation Temp. °F. 19

SOURCE OF INFORMATION GR-2626

DRILLER or DIGGER

ADDITIONAL DATA:

Log X Water Level Measurements Chemical Analysis Aquifer Test

REMARKS:

Sandy loam
Sand and gravel

2 19
19