

STATE ENGINEER
Salem, Oregon

LANE
7956

Well Record

STATE WELL NO. 16/4W-144
COUNTY LANE
APPLICATION NO. GR-2777

OWNER: E. B. Brown Jr.

MAILING ADDRESS: 1370 Maple Dr.

LOCATION OF WELL: Owner's No.

CITY AND STATE: Junction City, Oregon

NE 1/4 SW 1/4 Sec. 14 T. 16 N. S. R. 4 W. W.M.


Bearing and distance from section or subdivision

corner 2470' N. 39° 30' E.

Altitude at well

TYPE OF WELL: driven Date Constructed 1950

Depth drilled 21 Depth cased 21

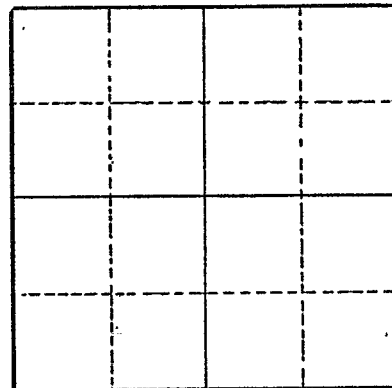

Section

CASING RECORD:

4-inch

FINISH:

3' of perforations size and number unknown

AQUIFERS:

Loam, sand and gravel

WATER LEVEL:

8-feet

PUMPING EQUIPMENT: Type Cornell Centrifugal H.P. 12
Capacity 150 G.P.M.

WELL TESTS:

Drawdown ft. after hours G.P.M.

Drawdown ft. after hours G.P.M.

USE OF WATER irrigation Temp. °F., 19

SOURCE OF INFORMATION GR-2624

DRILLER or DIGGER

ADDITIONAL DATA:

Log X Water Level Measurements Chemical Analysis Aquifer Test

REMARKS:

Sandy loam
Sand & gravel

6 15
15 0