

STATE ENGINEER
Salem, Oregon

LANE
757

Well Record

STATE WELL NO. 16/4W-14M
COUNTY Lane
APPLICATION NO. GR-2688

OWNER: Robert B. & Maxine Fullerton

MAILING

ADDRESS: Rt. 2, Junction City
& 910 Hughes

CITY AND

STATE: Eugene, Oregon

LOCATION OF WELL: Owner's No.

SW 1/4 SW 1/4 Sec. 14 T. 16 S. R. 4 W. W.M.

Bearing and distance from section or subdivision

corner 580' N. and 405' E.

Altitude at well

TYPE OF WELL: Driven Date Constructed 1946

Depth drilled 21' Depth cased 21'

CASING RECORD:

Two 4 inch

FINISH:

Standard perforations from 18 to 21

AQUIFERS:

loam, sand and gravel

WATER LEVEL:

12 feet

PUMPING EQUIPMENT: Type Centrifugal

H.P. 10

Capacity 300 G.P.M.

WELL TESTS:

Drawdown 2 ft. after hours pumping 400 G.P.M.

Drawdown ft. after hours G.P.M.

USE OF WATER irrigation Temp. °F. 19

SOURCE OF INFORMATION GR-2546


DRILLER or DIGGER

ADDITIONAL DATA:

Log X Water Level Measurements Chemical Analysis Aquifer Test

REMARKS:

Loam (top soil) 4 to 17
sand & gravel 17 to 0

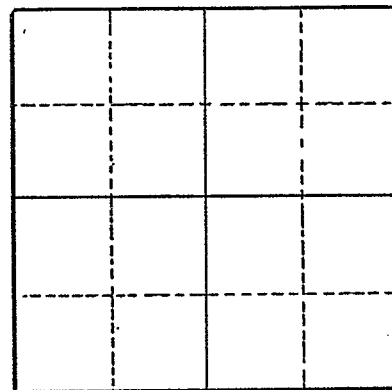

Section