

STATE ENGINEER  
Salem, Oregon

**LANE**  
759

# Well Record

STATE WELL NO. 16/4W-14P(2)  
COUNTY Lane  
APPLICATION NO. GR-1372

GR-1330

OWNER: Vincent Glover


MAILING ADDRESS: 1550 Maple Dr.

LOCATION OF WELL: Owner's No.

CITY AND STATE: Junction City, Oregon

SE 1/4 SW 1/4 Sec. 14 T. 16 N. S. R. 4 W., W.M.

Bearing and distance from section or subdivision corner N. 84° 55' E. 2380' from SW cor. Sec. 14.

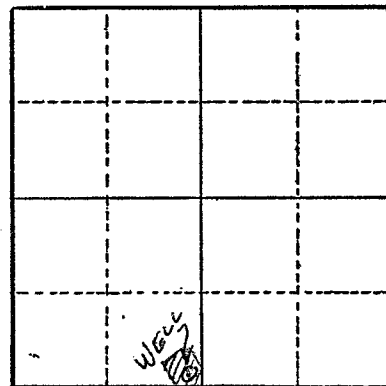

Section 14

Altitude at well 395 ft.

TYPE OF WELL: Driven Date Constructed 1944

Depth drilled 20 ft. Depth cased 20 ft.

### CASING RECORD:

2 - 3 in. pipes driven 6 ft. apart & connected

### FINISH:

Perforated with 12 - 1/4 in. slots from 17 to 20 ft.

### AQUIFERS:

### WATER LEVEL:

8 ft.

PUMPING EQUIPMENT: Type F. M. 2 in. Cent. H.P. 40  
Capacity 200 G.P.M.

### WELL TESTS:

Drawdown	ft. after	hours	G.P.M.
Drawdown	ft. after	hours	G.P.M.

USE OF WATER Irrigation Temp. °F. 19

SOURCE OF INFORMATION G. R. Record

DRILLER or DIGGER

### ADDITIONAL DATA:

Log Water Level Measurements Chemical Analysis Aquifer Test

### REMARKS:

Log: Sandy loam	0 to 10 ft.
Sand & gravel	10 to 20 ft.

Irrigation of 9.5 Acres.