


OWNER: E. B. Brown Jr. MAILING ADDRESS: 1370 Maple Drive

LOCATION OF WELL: Owner's No. #2 CITY AND STATE: Junction City, Oregon

SW 1/4 SE 1/4 Sec. 14 T. 16 N. 4 S. R. 4 E. W.M.

Bearing and distance from section or subdivision corner 2750' N. 77° 35' E.

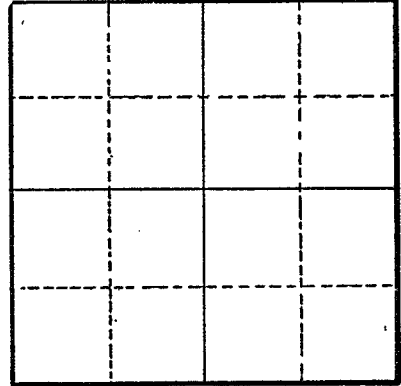

Section

Altitude at well

TYPE OF WELL: driven Date Constructed 1947

Depth drilled 22 Depth cased 22

CASING RECORD:

2-inch

FINISH:

Perforated 3' but size is unknown

AQUIFERS:

Loam, sand and gravel

WATER LEVEL:

8-feet

PUMPING EQUIPMENT: Type G.E. Centrifugal H.P. 5
Capacity 100 G.P.M.

WELL TESTS:

Drawdown ft. after hours G.P.M.
Drawdown ft. after hours G.P.M.

USE OF WATER irrigation Temp. °F. 19

SOURCE OF INFORMATION GR-2778 2625

DRILLER or DIGGER

ADDITIONAL DATA:
Log X Water Level Measurements Chemical Analysis Aquifer Test

REMARKS:

Sandy Loam 6 14
Sand and gravel 14 0