

STATE ENGINEER
Salem, Oregon

LANE
7976

Well Record

GR- 1491

STATE WELL NO. 16/4W-15E
COUNTY Lane
APPLICATION NO. GR-1445

OWNER: S. Bert Simmons

MAILING
ADDRESS:


LOCATION OF WELL: Owner's No.

CITY AND
STATE:

Junction City, Oregon

SW ^{XXX} 1/4 NW ^{EX} 1/4 Sec. 15 T. 16 S., R. 4 W., W.M.

Bearing and distance from section or subdivision
corner 712' E. & 600' N. from W¹/₄ cor. Sec. 15

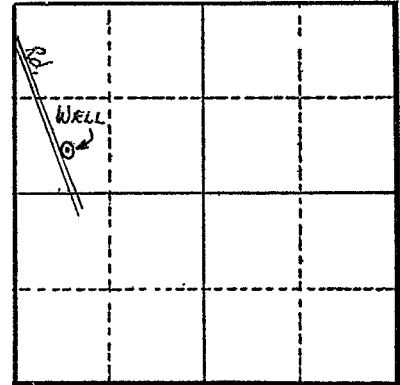

Section 15

Altitude at well 350'

TYPE OF WELL: Driven Date Constructed 1954

Depth drilled 29' Depth cased 29'

CASING RECORD:

4" & 2 1/2"

FINISH:

AQUIFERS:

WATER LEVEL:

14'

PUMPING EQUIPMENT: Type Jacuzzi H.P. 5

Capacity 150 G.P.M.

WELL TESTS:

Drawdown _____ ft. after _____ hours _____ G.P.M.

Drawdown _____ ft. after _____ hours _____ G.P.M.

USE OF WATER Irrigation Temp. _____ °F., 19

SOURCE OF INFORMATION GR Record

DRILLER or DIGGER Walter Nelson

ADDITIONAL DATA:

Log N.A. Water Level Measurements _____ Chemical Analysis _____ Aquifer Test _____

REMARKS:

Irrigation of 10 acres.