

STATE ENGINEER
Salem, Oregon

LANE
79777

Well Record

STATE WELL NO. 16/4W-15E(1)
COUNTY Lane
APPLICATION NO.

OWNER: William & Madge Harper

MAILING ADDRESS: 3650 River Rd.

LOCATION OF WELL: Owner's No. 2

CITY AND STATE: Junction City, Oregon


SW 1/4 NW 1/4 Sec. 15 T. 16 S, R. 4 W., W.M.

Bearing and distance from section or subdivision

corner N. 76° E. 3260' from SW cor. Wm. Brice DLC 50:

Well in SW 1/4 NW 1/4 Sec. 15, being approx. 650' E. &

300' N. from W 1/4 cor. Sec. 15

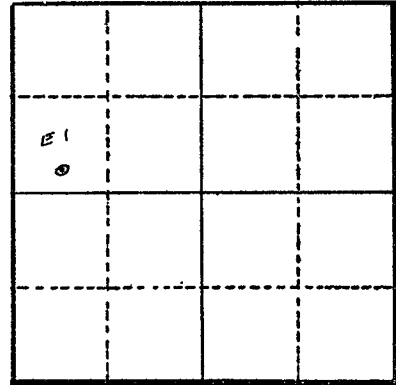

Section 15

Altitude at well 345 ft. Interpolated

TYPE OF WELL: driven Date Constructed Sept. 1953

Depth drilled 27' Depth cased 26'

CASING RECORD: 4 inch driven pipe set to 26 ft.

FINISH: Slots - 1/2" x 4" set from 4' to 26'

AQUIFERS: unknown

WATER LEVEL: 15 ft. below land surface

PUMPING EQUIPMENT: Type Fairbanks Morse 2 1/2" - 1 1/2" outlet 120' head H.P. Mod. A Tractor McCormick
Capacity 200 G.P.M.

WELL TESTS:

Drawdown 5 ft. after hours pumping 150 G.P.M.

Drawdown ft. after hours G.P.M.

USE OF WATER irrigation 40 acres Temp. °F. 19

SOURCE OF INFORMATION Reg. Statement GR-153

DRILLER or DIGGER

ADDITIONAL DATA:

Log No Water Level Measurements Chemical Analysis Aquifer Test

REMARKS: Test well only - not subject to registration.