

STATE ENGINEER
Salem, Oregon

LANE
7978


Well Record

STATE WELL NO. 16/4W-15E(2)
COUNTY Lane
APPLICATION NO. GR-153

OWNER: William & Madge Harper MAILING ADDRESS: 3650 River Road

LOCATION OF WELL: Owner's No. 3 CITY AND STATE: Junction City, Oregon

SW 1/4 NW 1/4 Sec. 15 T. 16 N. S. R. 4 W., W.M.
Bearing and distance from section or subdivision
corner 3094' N. 69° E. from SW cor. Wm. Brice DIC 50

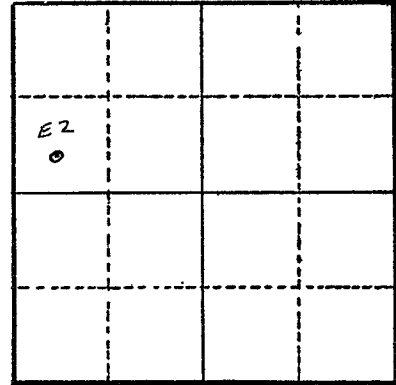

Section 15

Altitude at well 342' Interpolated

TYPE OF WELL: driven Date Constructed Sept. 1951

Depth drilled 28' Depth cased 28'

CASING RECORD: 3 - inch steel pipe set to 28 ft.

FINISH: 1/2" holes - 150 of these set from 4 to 28 ft.

AQUIFERS: unknown

WATER LEVEL: 15 ft. below land surface. Sept. 1951

PUMPING EQUIPMENT: Type _____ H.P. 3
Capacity 90 G.P.M.

WELL TESTS:
Drawdown 5 ft. after _____ hours 145 G.P.M.
Drawdown _____ ft. after _____ hours _____ G.P.M.

USE OF WATER irrigation 13 acres Temp. _____ °F. 19

SOURCE OF INFORMATION Registration Statement GR-153

DRILLER or DIGGER _____

ADDITIONAL DATA:
Log No _____ Water Level Measurements _____ Chemical Analysis _____ Aquifer Test _____

REMARKS: