

STATE ENGINEER
Salem, Oregon

LANE
7980

Well Record

STATE WELL NO. 16/4W-15K
COUNTY Lane
APPLICATION NO. GR-4135

OWNER: Mary E. Wing (owner)
H. S. Wing (renter)


MAILING ADDRESS: 3921 River Rd.

LOCATION OF WELL: Owner's No.

CITY AND STATE: Junction City, Oregon

NW 1/4 SE 1/4 Sec. 15 T. 16 S., R. 4 W., W.M.

Bearing and distance from section or subdivision
corner 3109' bearing 62° 30' from SW Cor., Sec. 15

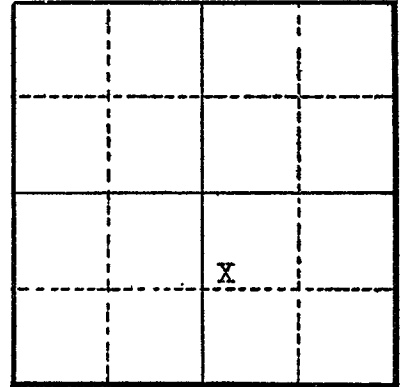

Section 15

Altitude at well

TYPE OF WELL: Driven Date Constructed 1939

Depth drilled 25 ft. Depth cased 25 ft.

CASING RECORD:

4 inch casing set from 22 to 25 feet

FINISH:

AQUIFERS:

WATER LEVEL:

14 feet below surface

PUMPING EQUIPMENT: Type Fairbanks Morse centrifugal 4 x 3 H.P. 15
Capacity 500 G.P.M.

WELL TESTS:

Drawdown ft. after hours G.P.M.
Drawdown ft. after hours G.P.M.

USE OF WATER Irrigation Temp. °F., 19

SOURCE OF INFORMATION Well Registration Statement Cert. # GR-3711

DRILLER or DIGGER

ADDITIONAL DATA:

Log Water Level Measurements Chemical Analysis Aquifer Test

REMARKS: