

STATE ENGINEER
Salem, Oregon.

LANE
7981

Well Record

STATE WELL NO. 16/4W-15L(1)
COUNTY Lane
APPLICATION NO. GR-154

OWNER: William Harper


MAILING ADDRESS: 3650 River Road

LOCATION OF WELL: Owner's No. 1

CITY AND STATE: Junction City, Oregon

NE 1/4 SW 1/4 Sec. 15 T. 16 S., R. 4 W., W.M.

Bearing and distance from section or subdivision
corner 4081' N. 89° 55' E. from SW cor. Sec. 16

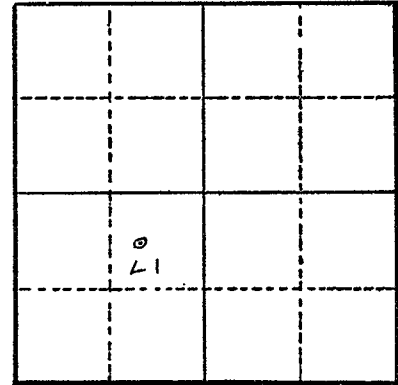

Altitude at well 347' Interpolated

Section 15

TYPE OF WELL: Dug Date Constructed Sept. 1940

Depth drilled 32' Depth cased

CASING RECORD: 4 - in. well tile set to 20 ft. - 4 in. pipe driven from 20 to 32 ft.

FINISH: none

AQUIFERS: unknown

WATER LEVEL: 15 ft. below land surface Sept. 1940

PUMPING EQUIPMENT: Type Ingersoll - Rand 3 phase H.P. 7 1/2
Capacity 200 G.P.M.

WELL TESTS:
Drawdown 4 ft. after pumping 190 hours G.P.M.
Drawdown ft. after hours G.P.M.

USE OF WATER irrigation 12 acres Temp. °F. 19

SOURCE OF INFORMATION Reg. State. GR-154

DRILLER or DIGGER

ADDITIONAL DATA:

Log No Water Level Measurements Chemical Analysis Aquifer Test

REMARKS: