

STATE ENGINEER  
Salem, Oregon

**LANE**  
783

# Well Record

STATE WELL NO. 16/4W-15M  
COUNTY Lane  
APPLICATION NO. GR-1304

GR-1261

OWNER: George Harper

MAILING ADDRESS:


LOCATION OF WELL: Owner's No. #2

CITY AND STATE:

Junction City, Oregon

NW 1/4 SW 1/4 Sec. 15 T. 16 S, R. 4 W., W.M.

Bearing and distance from section or subdivision corner N76° 37' E. 3267' from SW cor. DIC. #50.

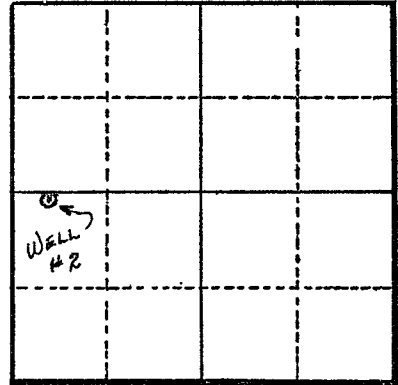

Altitude at well 350 ft.

Section 15

TYPE OF WELL: Driven Date Constructed 1953

Depth drilled 24 ft. Depth cased 24 ft.

### CASING RECORD:

4 inch

### FINISH:

### AQUIFERS:

### WATER LEVEL:

12 ft.

PUMPING EQUIPMENT: Type 2 1/2 x 3 in. Cent. H.P. 10  
Capacity 300 G.P.M.

### WELL TESTS:

Drawdown 5 ft. after \_\_\_\_\_ hours 300 G.P.M.  
Drawdown \_\_\_\_\_ ft. after \_\_\_\_\_ hours \_\_\_\_\_ G.P.M.

USE OF WATER Irrigation Temp. \_\_\_\_\_ °F. \_\_\_\_\_, 19

SOURCE OF INFORMATION G. R. Record

DRILLER or DIGGER

### ADDITIONAL DATA:

Log N.A. Water Level Measurements \_\_\_\_\_ Chemical Analysis \_\_\_\_\_ Aquifer Test \_\_\_\_\_

### REMARKS:

Irrigation of 40.2 acres.