

STATE ENGINEER
Salem, Oregon

LANE
7883

Well Record

STATE WELL NO. 16/4W-15N
COUNTY Lane
APPLICATION NO. GR-1357

GR-1312

OWNER: Florene K. Thurston


MAILING ADDRESS: 4130 River Rd.

LOCATION OF WELL: Owner's No. #1

CITY AND STATE: Junction City, Oregon

SW 1/4 SW 1/4 Sec. 15 T. 16 S., R. 4 W., W.M.

Bearing and distance from section or subdivision corner 1686.19' W. & 1200' S. from SE cor. DIC #50

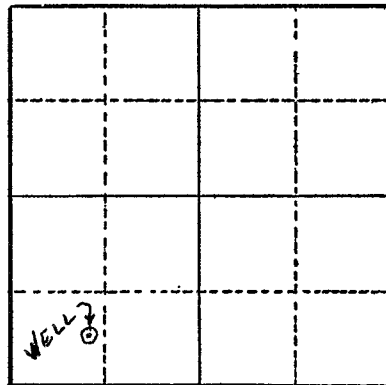

Section 15

Altitude at well 375 ft.

TYPE OF WELL: Driven Date Constructed 1952

Depth drilled 20 ft. Depth cased 20 ft.

CASING RECORD:

2 - 2 inch

FINISH:

Sand points

AQUIFERS:

WATER LEVEL:

12 ft.

PUMPING EQUIPMENT: Type Pacific Cent. H.P. 10
Capacity 250 G.P.M.

WELL TESTS:

Drawdown ft. after hours G.P.M.
Drawdown ft. after hours G.P.M.

USE OF WATER Irrigation Temp. °F. , 19

SOURCE OF INFORMATION G. R. Record

DRILLER or DIGGER Paeschko, Henry

ADDITIONAL DATA:

Log N.A. Water Level Measurements Chemical Analysis Aquifer Test

REMARKS:

Irrigation of 20 acres.