

STATE ENGINEER
Salem, Oregon

LANE
1984

Well Record


STATE WELL NO. 16/LW-15P
COUNTY Lane
APPLICATION NO. GR-4136

OWNER: Mary E. Wing (owner)
H. G. Wing (renter)
LOCATION OF WELL: Owner's No. _____

MAILING ADDRESS: 3921 River Road
CITY AND STATE: Junction City, Oregon

SE $\frac{1}{4}$ SW $\frac{1}{4}$ Sec. 15 T. 16 S., R. 4 W., W.M.

Bearing and distance from section or subdivision
corner 2429 ft. bearing 59° 25' from SW Cor.
Sec. 15

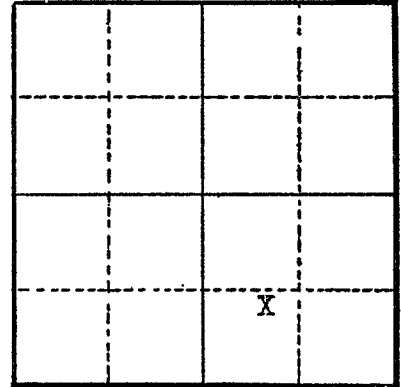

Section 15

Altitude at well _____

TYPE OF WELL: Driven Date Constructed 1939
Depth drilled 20 ft. Depth cased 20 ft.

CASING RECORD:

2 - 3 inch casing set to 20 ft.

FINISH:

Drilled holes from 17 to 20 feet

AQUIFERS:

WATER LEVEL:

12 feet below surface

PUMPING EQUIPMENT: Type Fairbanks Morse centrifugal H.P. 15
Capacity 500 G.P.M.

WELL TESTS:

Drawdown _____ ft. after _____ hours _____ G.P.M.
Drawdown _____ ft. after _____ hours _____ G.P.M.

USE OF WATER Irrigation Temp. _____ °F., 19 _____

SOURCE OF INFORMATION Well Registration Statement Cert. # GR-3712

DRILLER or DIGGER _____

ADDITIONAL DATA:

Log _____ Water Level Measurements _____ Chemical Analysis _____ Aquifer Test _____

REMARKS: