

STATE ENGINEER  
Salem, Oregon

**LANE** Well Record  
2025

STATE WELL NO. 16/4W-15P  
COUNTY Lane  
APPLICATION NO. GR-3685

OWNER: Gordon G. Frost


MAILING ADDRESS: 4127 River Road

LOCATION OF WELL: Owner's No. \_\_\_\_\_

CITY AND STATE: Junction City, Oregon

SE 1/4 SW 1/4 Sec. 15 T. 16 S., R. 4 W., W.M.

Bearing and distance from section or subdivision corner N. 78° E. 1900' from SW cor. Sec. 15

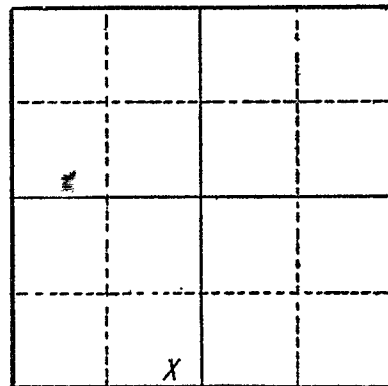

Section 15

Altitude at well \_\_\_\_\_

TYPE OF WELL: Driven Date Constructed 1952

Depth drilled 21 feet Depth cased 21 feet

CASING RECORD:

4 inch casing set to 21 feet

FINISH:

slotted perforations from 18 to 21 feet

AQUIFERS:

WATER LEVEL:

PUMPING EQUIPMENT: Type Centrifugal H.P. \_\_\_\_\_  
Capacity 200 G.P.M.

WELL TESTS:

Drawdown \_\_\_\_\_ ft. after \_\_\_\_\_ hours \_\_\_\_\_ G.P.M.  
Drawdown \_\_\_\_\_ ft. after \_\_\_\_\_ hours \_\_\_\_\_ G.P.M.

USE OF WATER Irrigation Temp. \_\_\_\_\_ °F., 19 \_\_\_\_\_

SOURCE OF INFORMATION Well Registration Statement

DRILLER or DIGGER \_\_\_\_\_

ADDITIONAL DATA:

Log \_\_\_\_\_ Water Level Measurements \_\_\_\_\_ Chemical Analysis \_\_\_\_\_ Aquifer Test \_\_\_\_\_

REMARKS: