

STATE ENGINEER
Salem, Oregon

LANE Well Record
1986


STATE WELL NO. 16/4W-15P
COUNTY Lane
APPLICATION NO. GR-3686

OWNER: Gordon G. Frost
MAILING ADDRESS: 4127 River Road

LOCATION OF WELL: Owner's No. _____
CITY AND STATE: Junction City, Oregon

SE 1/4 SW 1/4 Sec. 15 T. 16 S., R. 4 W., W.M.

Bearing and distance from section or subdivision
corner N. 79° E. 2360' from SW cor. Sec. 15

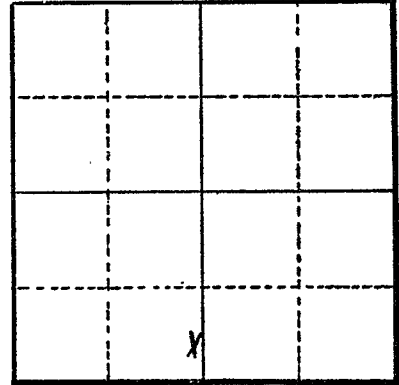

Section 15

Altitude at well _____

TYPE OF WELL: Driven Date Constructed 1950

Depth drilled 21 feet Depth cased 21 feet

CASING RECORD:

4 inch casing set to 21 feet

FINISH:

slotted perforations 1" x 3" from 18 to 21 feet

AQUIFERS:

WATER LEVEL:

21 feet below surface

PUMPING EQUIPMENT: Type Berkeley centrifugal H.P. 20
Capacity 400 G.P.M.

WELL TESTS:

Drawdown _____ ft. after _____ hours _____ G.P.M.
Drawdown _____ ft. after _____ hours _____ G.P.M.

USE OF WATER Irrigation Temp. _____ °F., 19

SOURCE OF INFORMATION Well Registration Statement

DRILLER or DIGGER _____

ADDITIONAL DATA:

Log _____ Water Level Measurements _____ Chemical Analysis _____ Aquifer Test _____

REMARKS:

3378