

STATE ENGINEER
Salem, Oregon

LANE
7989

Well-Record

STATE WELL NO. 16/4W-150
COUNTY Lane
APPLICATION NO. GR-3088

OWNER: Edward C. Falk, Jr.


MAILING ADDRESS: Route 2, Box 697

LOCATION OF WELL: Owner's No. 1

CITY AND STATE: Junction City, Oregon

SW 1/4 SE 1/4 Sec. 15 T. 16 N. S., R. 4 W., W.M.

Bearing and distance from section or subdivision corner 1600 feet W. and 420 feet N.

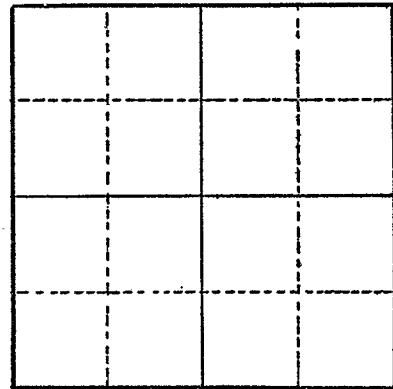

Section

Altitude at well

TYPE OF WELL: Driven Date Constructed 1947

Depth drilled 20' Depth cased 20'

CASING RECORD:

4"

FINISH:

perforated from 16 to 20'

AQUIFERS:

sand, loam, gravel, sand

WATER LEVEL:

12'

PUMPING EQUIPMENT: Type F. B. M., 3" x 4" H.P. 20
Capacity 450 G.P.M.

WELL TESTS:

Drawdown ft. after hours G.P.M.

Drawdown ft. after hours G.P.M.

USE OF WATER Irrigation Temp. °F., 19

SOURCE OF INFORMATION GR-2891

DRILLER or DIGGER

ADDITIONAL DATA:

Log ^x Water Level Measurements Chemical Analysis Aquifer Test

REMARKS:

Sand Loam	0	5	5
Gravel	5	11	6
Sand	11	16	5
Gravel	16	20	4