

STATE ENGINEER  
Salem, Oregon

LANE  
8020

# Well Record

STATE WELL NO. 16/4W-16A  
COUNTY Lane  
APPLICATION NO. GR-1303

GR- 1260

OWNER: George Harper

MAILING  
ADDRESS:

LOCATION OF WELL: Owner's No. #1


CITY AND  
STATE:

Junction City, Oregon

NE 1/4 NE 1/4 Sec. 16 T. 16 S., R. 4 W., W.M.

Bearing and distance from section or subdivision

corner S84°31'1/2"W. 587.9' from NE cor. Sec. 16

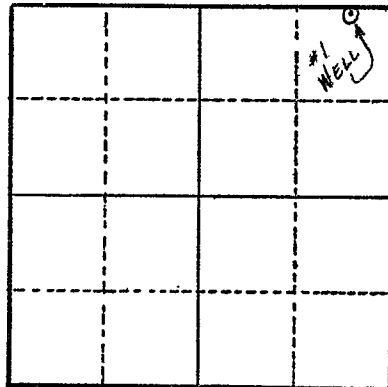

Section 16

Altitude at well 338 ft.

TYPE OF WELL: Drilled Date Constructed 1944

Depth drilled 24 ft. Depth cased 24 ft.

### CASING RECORD:

4 inch

### FINISH:

Perforated from 21 to 24 ft.

### AQUIFERS:

### WATER LEVEL:

12 ft.

PUMPING EQUIPMENT: Type 2 1/2 x 3 in. Cent. H.P. 35  
Capacity 350 G.P.M.

### WELL TESTS:

Drawdown 5 ft. after 180 hours G.P.M.

Drawdown ft. after hours G.P.M.

USE OF WATER Irrigation Temp. °F. 19

SOURCE OF INFORMATION G. R. Record

DRILLER or DIGGER

### ADDITIONAL DATA:

Log N.A. Water Level Measurements Chemical Analysis Aquifer Test

### REMARKS:

Irrigation of 9.7 acres.