

STATE ENGINEER
Salem, Oregon

LANE
8022

Well Record


STATE WELL NO. 16/4W-16A(2)
COUNTY Lane
APPLICATION NO. GR-155

OWNER: William & Madge Harper MAILING ADDRESS: 3650 River Road

LOCATION OF WELL: Owner's No. 6 CITY AND STATE: Junction City, Oregon

NE 1/4 NE 1/4 Sec. 16 T. 16 S., R. 4 W., W.M.

Bearing and distance from section or subdivision
corner 3905 ft. N. 40° E. from SW cor. Wm. Brice
DLC 50

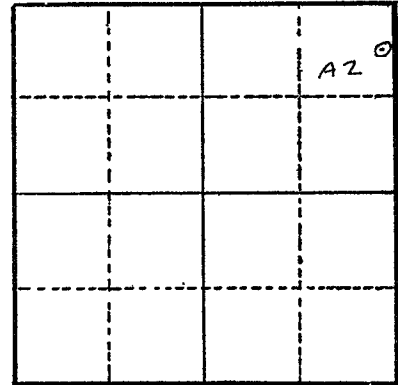

Section 16

Altitude at well 339 ft. Interpolated

TYPE OF WELL: dug & driven Date Constructed Aug. 1940

Depth drilled 25 ft. Depth cased 25 ft.

CASING RECORD: 3 - in. pipe backfilled in old open dug well; set to 25 ft.

FINISH: 150 - 1/2" holes from 4 to 25 ft.

AQUIFERS: unknown

WATER LEVEL: 14 ft. below land surface Sept. 1940

PUMPING EQUIPMENT: Type Fairbanks Morse 120 ft. head H.P. tractor eng.
Capacity 200 G.P.M.

WELL TESTS:
Drawdown ? ft. after hours pumping 200 G.P.M.
Drawdown ? ft. after hours G.P.M.

USE OF WATER irrigation 20 acres Temp. °F. 19

SOURCE OF INFORMATION Reg. State GR-155

DRILLER or DIGGER

ADDITIONAL DATA:
Log No. Water Level Measurements Chemical Analysis Aquifer Test

REMARKS: