

LANE
8031

Well Record

OWNER: William & Madge Harper


MAILING ADDRESS: 3650 River Road

LOCATION OF WELL: Owner's No. 4

CITY AND STATE: Junction City, Oregon

SE 1/4 NE 1/4 Sec. 16 T. 16 N. S., R. 4 W., W.M.

Bearing and distance from section or subdivision
corner 2437.5 ft. N. 59° 30' E. from SW cor.
Wm. Brice DLG 50

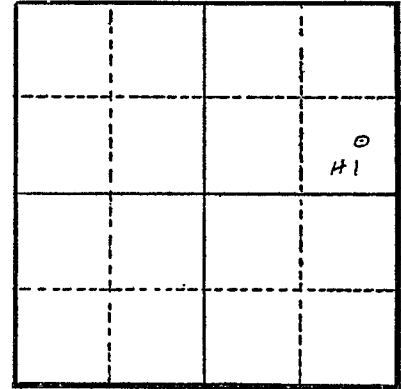

Section 16

Altitude at well 342 ft. Interpolated

TYPE OF WELL: driven Date Constructed May 1954

Depth drilled 28 ft. Depth cased 28 ft.

CASING RECORD: 3 - in. gal. iron pipe driven to 28 ft.

FINISH: 150 - 1/2" holes from 4 to 28 ft.

AQUIFERS: unknown

WATER LEVEL: 12 ft. below land surface May 1954

PUMPING EQUIPMENT: Type Fairbanks Morse McCormick
Capacity 200 G.P.M. H.P. Tractor

WELL TESTS:
Drawdown 5 ft. after pumping 175 hours G.P.M.
Drawdown ft. after hours G.P.M.

USE OF WATER irrigation 27 acres Temp. °F., 19

SOURCE OF INFORMATION Reg. State. GR-153

DRILLER or DIGGER

ADDITIONAL DATA:

Log No. Water Level Measurements Chemical Analysis Aquifer Test

REMARKS: