

STATE ENGINEER
Salem, Oregon

LANE
8039

Well Record

STATE WELL NO. 16/LW-17G
COUNTY Lane
APPLICATION NO. GR-3138

OWNER: Bernard A. Kokkeler


MAILING ADDRESS: 2640 Prairie Road

LOCATION OF WELL: Owner's No.

CITY AND STATE: Junction City, Oregon

S¹/₂ SW 1/4 NE 1/4 Sec. 17 T. 16 N. S. R. 4 W., W.M.

Bearing and distance from section or subdivision corner 1700' W. 3100' N.

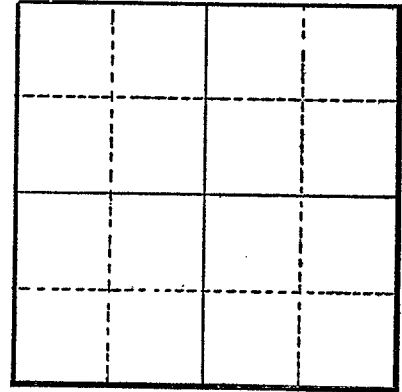

Section

Altitude at well

TYPE OF WELL: Driven Date Constructed 1952

Depth drilled 20' Depth cased 20'

CASING RECORD:

4"

FINISH:

AQUIFERS:

- Silt Loam
- Clay Loam
- Sand and Gravel

WATER LEVEL:

11'

PUMPING EQUIPMENT: Type Centrifugal 1 1/2 H.P. 3
Capacity 150 G.P.M.

WELL TESTS:

Drawdown ft. after hours G.P.M.

Drawdown ft. after hours G.P.M.

USE OF WATER Irrigation Temp. °F. 19

SOURCE OF INFORMATION GR-2943

DRILLER or DIGGER

ADDITIONAL DATA:

Log Water Level Measurements Chemical Analysis Aquifer Test

REMARKS:

Silt Loam	4	4
Clay Loam	2	3
Sand and Gravel	12	20