

STATE ENGINEER
Salem, Oregon

LANE
8041

Well Record

GR- 1269

STATE WELL NO. 16/4W-17J
COUNTY Lane
APPLICATION NO. GR- 1312

OWNER: Warren L. Averill

MAILING

ADDRESS: 3003 Prairie Rd.

LOCATION OF WELL: Owner's No.


CITY AND

STATE: Junction City, Oregon

NE 1/4 SE 1/4 Sec. 17 T. 16 S., R. 4 W., W.M.

Bearing and distance from section or subdivision

corner 305' W. & 655' N. to NW cor. of NE 1/4 SE 1/4
of Section 17.

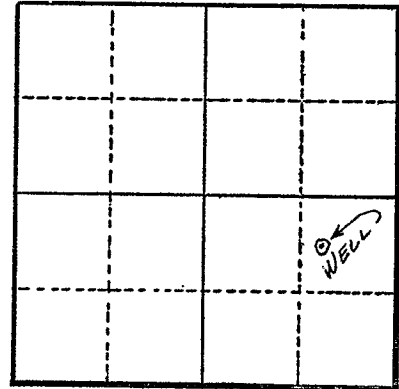

Altitude at well 326 ft.

TYPE OF WELL: Drilled Date Constructed 1953

Depth drilled 40 ft. Depth cased

Section 17

CASING RECORD:

5 inch

FINISH:

Perforated: 1/10 x 6 in. slots from 0 to 40 ft.

AQUIFERS:

WATER LEVEL:

7 1/2 ft. (July 1957)

PUMPING EQUIPMENT: Type Berkeley

H.P. 3

Capacity 60 G.P.M.

WELL TESTS:

Drawdown Dry ft. after Early hours 63 G.P.M.

Drawdown Dry ft. after August hours 35 G.P.M.

USE OF WATER Irrigation Temp. °F. 19

SOURCE OF INFORMATION G. R. Record

DRILLER or DIGGER Mark Christiansen

ADDITIONAL DATA:

Log Water Level Measurements Chemical Analysis Aquifer Test

REMARKS:

Log: Mixture of gravel, loam & sand all the way till we hit clay at about 40 ft.

Irrigation of 10 acres.