

STATE ENGINEER
Salem, Oregon

LANE
8043

Well Record

STATE WELL NO. 16/4W-18B
COUNTY Lane
APPLICATION NO. GR-3562

OWNER: J. Earl Lorang & Olive B. Lorang

MAILING

ADDRESS: Star Route

LOCATION OF WELL: Owner's No.

CITY AND


STATE: Junction City, Oregon

NW 1/4 NE 1/4 Sec. 18 T. 16 S., R. 4 W., W.M.

Bearing and distance from section or subdivision

corner 440 ft. S. and 1785 ft. W. of NE corner

Sec. 18

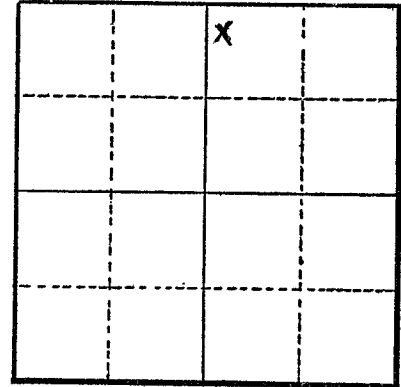

Section 18

Altitude at well

TYPE OF WELL: Driven Date Constructed 1950

Depth drilled 28 ft. Depth cased 28 ft.

CASING RECORD:

4 inch casing set to 28 feet

FINISH:

Standard perforations from 24 to 28 feet

AQUIFERS:

sand and gravel

WATER LEVEL:

12 feet below surface

PUMPING EQUIPMENT: Type Pacific centrifugal electric H.P. 7 1/2
Capacity 150 G.P.M.

WELL TESTS:

Drawdown 4 ft. after 60 hours G.P.M.

Drawdown ft. after hours G.P.M.

USE OF WATER Irrigation Temp. °F. 19

SOURCE OF INFORMATION Well Registration Statement

DRILLER or DIGGER

ADDITIONAL DATA:

Log X Water Level Measurements Chemical Analysis Aquifer Test

REMARKS:

Log:

Top soil clean
Sandy clay subsoil
Sand and gravel

Thickness Depth to Bottom

2 26
3 23
23 0



Oregon Water Resources Department
725 Summer Street NE, Suite A
Salem Oregon 97301
(503) 986-0900
www.oregon.gov/owrd

Application for Well ID Number

RECEIVED

SEPT 17 2025

OWRD

Do not complete if the well already has a Well Identification Number.

I. OWNER INFORMATION

Current Owner Name (please print): Stuart Suhar

Mailing Address: 92950 S Pitney Ln

City, State, Zip: Junction City, OR 97448

Mail Well ID to: ☒ SAME AS ABOVE ☐ In Care Of (C/O)

Name & Address: _____

City, State, Zip: _____

II. WELL LOCATION INFORMATION (Please fill out as completely as possible)

Township: 16 S (North / South) Range: 4 W (East / West) Section: 18 NW 1/4 of the NE 1/4

Tax Lot (usually last 3-5 numbers of Tax Map #): 301 County Lane

GPS Coordinates: 44.184967 -123.2155

Street Address of Well, City: 92950 S Pitney Ln

If the property had a different street address in the past: _____

III. GENERAL WELL INFORMATION (Please fill out as completely as possible, AND attach copy of Well Report, if available)

Use of Well (domestic, irrigation, commercial, industrial, monitoring): Irrigation

Date Well Constructed (or property built): _____ Total Well Depth: 28' Casing Diameter: 4"

Owner at time the well was constructed (if known): _____ Well Report # (if known): LANE 8043

Other Information: Water Right Claim GR-3562; Well 1 of 5

SUBMITTED BY (please print): Stuart Suhar

PHONE: 541 378 7000

EMAIL &/or FAX: ralphfurley45@gmail.com

To send the completed application, you may MAIL it to: Oregon Water Resources Dept. 725 Summer St NE, Suite A, Salem, Oregon 97301.
Or EMAIL the completed PDF form to: Ladeena.K.Ashley@water.oregon.gov, or FAX it to: (503) 986-0902.

For Official Use Only by the Oregon Water Resources Department:

Received Date:

9-17-2025

Well Report Number:

LANE 8043

Well Identification #:

L-159241

House well (well 2 of 5)



Received
SEP 22 2025

OWRD