


LANE
8087

Well Record

OWNER: Thayer Dickey
MAILING ADDRESS: 602 Maple Drive
CITY AND STATE: Junction City, Oregon

LOCATION OF WELL: Owner's No. 2
NE 1/4 NE 1/4 Sec. 22 T. 16 S., R. 4 W., W.M.
Bearing and distance from section or subdivision corner South 47° 05' West 738 feet from corner common to Sections 14, 15, 22, and 23.

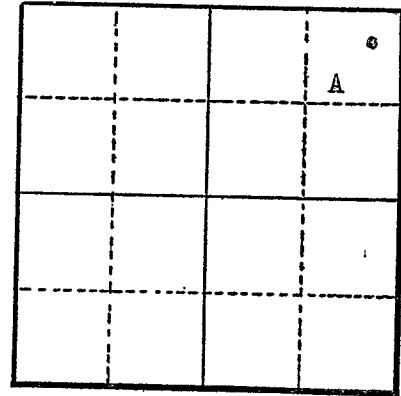

Section 22

Altitude at well

TYPE OF WELL: Driven Date Constructed 5-18-43
Depth drilled 21 feet Depth cased

CASING RECORD:

FINISH:

Drilled pipe
Six rows 3/8" holes 3' long

AQUIFERS:

loam, boulders, rock, and sand

WATER LEVEL:

10 feet

PUMPING EQUIPMENT: Type Fairbanks Morse 4 in. 3 in. discharge H.P.
Capacity 505 G.P.M.

WELL TESTS:

Drawdown ft. after hours 450 G.P.M.
Drawdown ft. after hours G.P.M.

USE OF WATER Irrigation Temp. °F., 19

SOURCE OF INFORMATION GR-4020

DRILLER or DIGGER

ADDITIONAL DATA:

Log Water Level Measurements Chemical Analysis Aquifer Test

REMARKS:

8' loam 13' boulders, rock, and sand