

STATE ENGINEER
Salem, Oregon

LANE
2088

Well Record

STATE WELL NO. 16/4W-22B
COUNTY Lane
APPLICATION NO. GR-3089

OWNER: Edward C. Falk, Jr.


MAILING ADDRESS: Route 2, Box 697

LOCATION OF WELL: Owner's No.

CITY AND STATE: Junction City, Oregon

NW 1/4 NE 1/4 Sec. 22 T. 16 N. S. R. 4 E. W. W.M.

Bearing and distance from section or subdivision corner 1700 feet W. and 180 feet S.

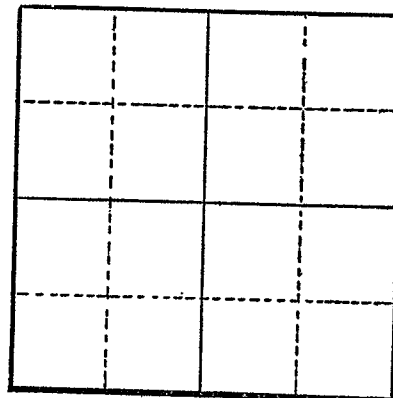

Section

Altitude at well

TYPE OF WELL: Driven Date Constructed 1951

Depth drilled 20 feet Depth cased 20 feet

CASING RECORD:

4-inch

FINISH:

Perforated from 16' to 20'

AQUIFERS:

Gravel and sand

WATER LEVEL:

12 feet

PUMPING EQUIPMENT: Type F. B. M. Gen. 3" x 4"

Capacity 450

G.P.M.

H.P. 20

WELL TESTS:

Drawdown ft. after hours G.P.M.

Drawdown ft. after hours G.P.M.

USE OF WATER Irrigation

Temp. °F. 19

SOURCE OF INFORMATION GR-2892

DRILLER or DIGGER

ADDITIONAL DATA:

Log Water Level Measurements Chemical Analysis Aquifer Test

REMARKS:

Dug in old gravel pit, 8' does not include 20' of well	0	8	8
Gravel	8	11	3
Sand	11	19	8
Gravel	19	28	9