

STATE ENGINEER
Salem, Oregon

LANE
8092

Well Record


STATE WELL NO. 16/4W-22C
COUNTY Lane
APPLICATION NO. GR-4226

OWNER: Thayer Dickey MAILING ADDRESS: 602 Maple Drive

LOCATION OF WELL: Owner's No. 4 CITY AND STATE: Junction City, Oregon

NE 1/4 NW 1/4 Sec. 22 T. 16 N. S. R. 4 W., W.M.

Bearing and distance from section or subdivision corner South 54° 05' East 1830 feet from the corner common to Sections 15, 16, 21, and 22

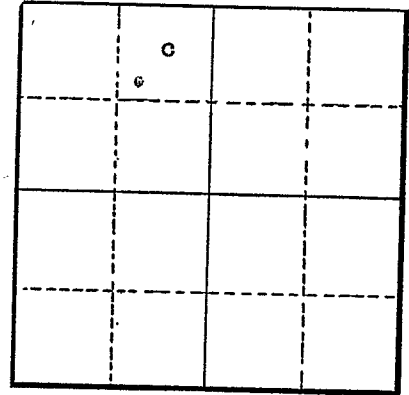

Section 22

Altitude at well

TYPE OF WELL: Driven Date Constructed 5-6-40

Depth drilled 26 feet Depth cased

CASING RECORD:

FINISH:

Slotted pipe
Slots 3' long 1/4" wide
Six rows 3' long

AQUIFERS:

rock and sand

WATER LEVEL:

14 feet

PUMPING EQUIPMENT: Type Fairbanks Morse 4" in 3" discharge H.P.
Capacity 505 G.P.M.

WELL TESTS:

Drawdown 7 ft. after 300 hours G.P.M.

Drawdown ft. after hours G.P.M.

USE OF WATER Irrigation Temp. °F., 19

SOURCE OF INFORMATION GR-4022

DRILLER or DIGGER

ADDITIONAL DATA:

Log Water Level Measurements Chemical Analysis Aquifer Test

REMARKS:

6' loam and small rock
3' pea. and sand
17' rock and sand