

LANE  
8096

# Well Record

STATE WELL NO. 16/4W-22D  
COUNTY LANE  
APPLICATION NO. GR-2724

OWNER: Ruby W. Dunn


MAILING ADDRESS: 4246 Riverroad

LOCATION OF WELL: Owner's No.

CITY AND STATE: Junction City, Oregon

NW 1/4 NW 1/4 Sec. 22 T. 16 N. S., R. 4 W., W.M.

Bearing and distance from section or subdivision corner 50' S. & 1200' E.

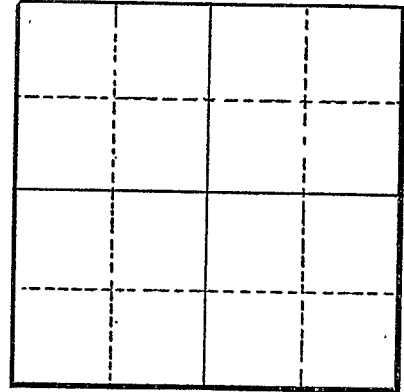

Section

Altitude at well

TYPE OF WELL: driven Date Constructed 1943

Depth drilled 21 Depth cased 21

### CASING RECORD:

2-inch

### FINISH:

1/4" drilled holes 3" centers from 17 to 21

### AQUIFERS:

Loam, Clay, sand and gravel

### WATER LEVEL:

12-feet

PUMPING EQUIPMENT: Type Johnston Jet Centrifugal

H.P. 1 1/2

Capacity 120 G.P.M.

### WELL TESTS:

Drawdown 2 ft. after hours Pumping 80 G.P.M.

Drawdown ft. after hours G.P.M.

USE OF WATER irrigation

Temp. °F. 19

SOURCE OF INFORMATION GR-2577

DRILLER or DIGGER

### ADDITIONAL DATA:

Log  Water Level Measurements Chemical Analysis Aquifer Test

### REMARKS:

Loam (Topsoil)	4	17
Clay Loam	3	10
Sand & gravel	10	0'