

LANE
8101


Well Record

STATE WELL NO. 16/4W-22G
COUNTY Lane
APPLICATION NO. GR-3657

OWNER: W. D. Loffelmacher
MAILING ADDRESS: Route 2
CITY AND STATE: Junction City, Oregon

LOCATION OF WELL: Owner's No.
SW 1/4 NE 1/4 Sec. 22 T. 16 N. R. 4 W. W.M.

Bearing and distance from section or subdivision
corner 2100' W. 1340' S. from NE cor. Sec. 22

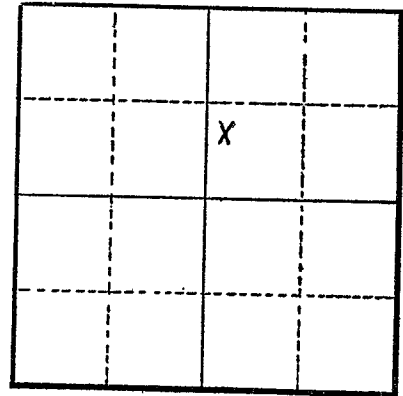

Section 22

Altitude at well

TYPE OF WELL: Driven Date Constructed May, 1944

Depth drilled 20 feet Depth cased 21 feet

CASING RECORD:

4 inch casing set to 21 feet

FINISH:

perforations from 18 to 21 feet

AQUIFERS:

WATER LEVEL:

14 feet below surface

PUMPING EQUIPMENT: Type Fairbanks Morse H.P.
Capacity 500 G.P.M.

WELL TESTS:

Drawdown 2 ft. after hours 600 G.P.M.

Drawdown ft. after hours G.P.M.

USE OF WATER Intermittently Temp. °F. 19

SOURCE OF INFORMATION Well Registration Statement

DRILLER or DIGGER H. O. Poeschke

ADDITIONAL DATA:

Log Water Level Measurements Chemical Analysis Aquifer Test

REMARKS: