

STATE ENGINEER
Salem, Oregon

LANE
8102

Well Record

STATE WELL NO. 16/4W-22H
COUNTY Lane
APPLICATION NO. GR-3658

OWNER: W. D. Loffelmacher


MAILING ADDRESS: Route 2

LOCATION OF WELL: Owner's No. _____

CITY AND STATE: Junction City, Oregon

SE 1/4 NE 1/4 Sec. 22 T. 16 S., R. 4 W., W.M.

Bearing and distance from section or subdivision
corner 450' W. 1800' S. from NE cor. Sec. 22

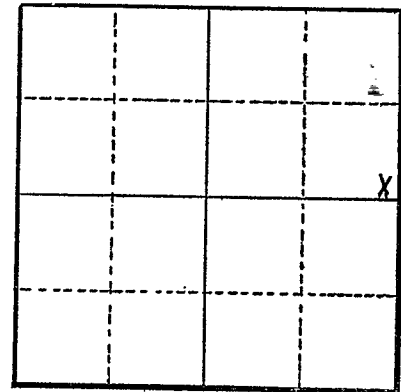

Section 22

Altitude at well _____

TYPE OF WELL: Driven Date Constructed May, 1944

Depth drilled 20 feet Depth cased 21 feet

CASING RECORD:

3 inch casing set to 21 feet

FINISH:

perforations from 18 to 21 feet

AQUIFERS:

WATER LEVEL:

10 feet below surface

PUMPING EQUIPMENT: Type Fairbanks Morse

Capacity 500 G.P.M. H.P. _____

WELL TESTS:

Drawdown 2 ft. after _____ hours 500 G.P.M.

Drawdown _____ ft. after _____ hours _____ G.P.M.

USE OF WATER Irrigation Temp. _____ °F., 19____

SOURCE OF INFORMATION Well Registration Statement

DRILLER or DIGGER Walt Dickinson

ADDITIONAL DATA:

Log _____ Water Level Measurements _____ Chemical Analysis _____ Aquifer Test _____

REMARKS: