

LANE
8104


Well Record

OWNER: Elmer & Ethel Lehman MAILING ADDRESS: 401 Lone Pine Dr.

LOCATION OF WELL: Owner's No. 1 CITY AND STATE: Junction City, Oregon

SE 1/4 NE 1/4 Sec. 22 T. 16 N S., R. 4 E W., W.M.

Bearing and distance from section or subdivision
corner N. 40° W. 1055 ft. from SE cor. E.D. Judkins
DLC 47

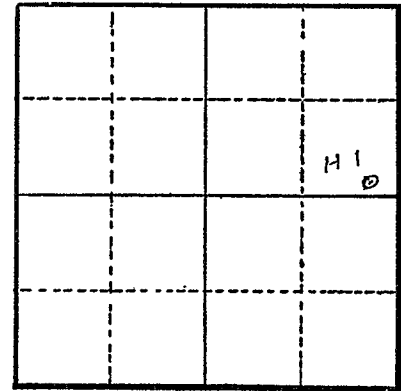

Section 22

Altitude at well 340

TYPE OF WELL: driven Date Constructed Apr. 1952

Depth drilled 20 Depth cased _____

CASING RECORD: 2 - 4 inch pipes

FINISH:

AQUIFERS:

WATER LEVEL: 10

PUMPING EQUIPMENT: Type F. M. centrifugal H.P. 30
Capacity 360 G.P.M.

WELL TESTS:
Drawdown _____ ft. after _____ hours _____ G.P.M.
Drawdown _____ ft. after _____ hours _____ G.P.M.

USE OF WATER irrigation 7 acres Temp. _____ °F., 19

SOURCE OF INFORMATION GR-467

DRILLER or DIGGER owner

ADDITIONAL DATA:
Log Water Level Measurements _____ Chemical Analysis _____ Aquifer Test _____

REMARKS: Log: Sandy loam 0 to 4 ft.
Gravel 4 to 20 ft.