

STATE ENGINEER
Salem, Oregon

LANE
8106

Well Record


STATE WELL NO. 16/4W-22J
COUNTY Lane
APPLICATION NO. GR-3767

OWNER: S. P. Hughes MAILING ADDRESS: 440 Lone Pine Drive

LOCATION OF WELL: Owner's No. _____ CITY AND STATE: Junction City, Oregon

NE 1/4 SE 1/4 Sec. 22 T. 16 S., R. 4 W., W.M.

Bearing and distance from section or subdivision
corner 2900 ft. S. 69° 35' W. of center of Sec. 23

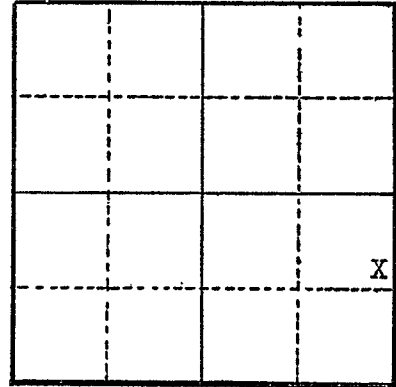

Altitude at well _____

TYPE OF WELL: Driven Date Constructed Feb., 1952

Depth drilled 21 feet Depth cased 21 feet

Section 22

CASING RECORD:

4 inch casing set to 21 feet

FINISH:

4 inch pipe perforated up 4 feet from the end

AQUIFERS:

WATER LEVEL:

16 feet below surface

PUMPING EQUIPMENT: Type Berkley centrifugal H.P. 5
Capacity 150 G.P.M.

WELL TESTS:

Drawdown _____ ft. after _____ hours _____ G.P.M.
Drawdown _____ ft. after _____ hours _____ G.P.M.

USE OF WATER Irrigation Temp. _____ °F., 19 _____

SOURCE OF INFORMATION Well Registration Statement

DRILLER or DIGGER _____

ADDITIONAL DATA:

Log X Water Level Measurements _____ Chemical Analysis _____ Aquifer Test _____

REMARKS:

Log:	Thickness	Depth to Bottom
Sandy Loam	14	7
Sand & gravel	7	0

5128