

STATE ENGINEER
Salem, Oregon

LANE
8107

Well Record

STATE WELL NO. 16/4W-22J(1)
COUNTY Lane
APPLICATION NO. GR-468

OWNER: Elmer & Ethel Lehman

MAILING

ADDRESS: 401 Lone Pine Dr.

LOCATION OF WELL: Owner's No. 2

CITY AND


STATE: Junction City, Oregon

NE 1/4 SE 1/4 Sec. 22 T. 16 S., R. 4 W., W.M.

Bearing and distance from section or subdivision

corner N. 51° W. 525 ft. from SE cor. E. D. Judkins

DLC 7

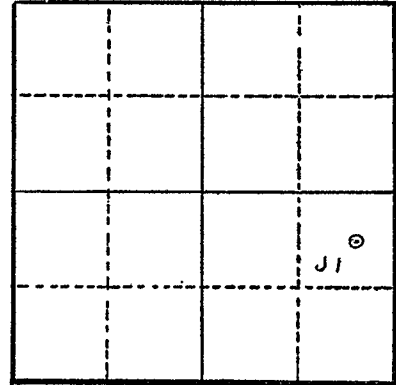

Altitude at well 340

TYPE OF WELL: driven Date Constructed June 1954

Depth drilled 24 Depth cased

Section 22

CASING RECORD: 3 inch

FINISH:

AQUIFERS:

WATER LEVEL: 10 ft.

PUMPING EQUIPMENT: Type Demming centrifugal H.P. 28
Capacity 120 G.P.M.

WELL TESTS:

Drawdown ft. after hours G.P.M.

Drawdown ft. after hours G.P.M.

USE OF WATER irrigation 11 acres Temp. °F. 19

SOURCE OF INFORMATION GR-468

DRILLER or DIGGER Curtice Miller

ADDITIONAL DATA:

Log Water Level Measurements Chemical Analysis Aquifer Test

REMARKS: Log: Sandy clay 0 to 4 ft.
Gravel 4 to 24 ft.