

STATE ENGINEER
Salem, Oregon

LANE
8108

Well Record

GR- 1218


STATE WELL NO. 16/4W-22J(2)
COUNTY Lane
APPLICATION NO. GR- 1262

OWNER: Clarence & Hazel Bond MAILING ADDRESS: 6265 River Rd.

LOCATION OF WELL: Owner's No. #2 CITY AND STATE: Junction City, Oregon

NE 1/4 SE 1/4 Sec. 22 T. 16 S., R. 4 W., W.M.

Bearing and distance from section or subdivision
corner 21 ch. N. & 17.5 ch. W. from SE cor. Sec. 22.

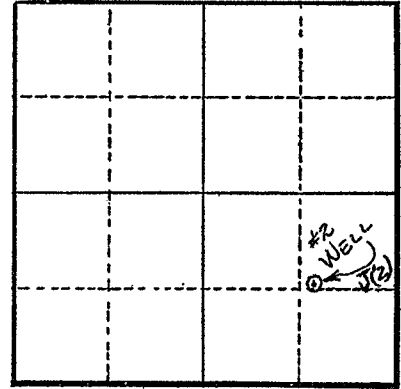

Section 22

Altitude at well 344 ft.

TYPE OF WELL: Driven Date Constructed 1955

Depth drilled 25 ft. Depth cased 25 ft.

CASING RECORD:

4 inch

FINISH:

Perforated: 1/4 x 5 in. - 4 per ft. from 20 to 25 ft.

AQUIFERS:

WATER LEVEL:

12 ft.

PUMPING EQUIPMENT: Type Cornell Cent. H.P. 15
Capacity 325 G.P.M.

WELL TESTS:

Drawdown 14 ft. after hours 325 G.P.M.
Drawdown ft. after hours G.P.M.

USE OF WATER Irrigation Temp. °F., 19.

SOURCE OF INFORMATION G. R. Record

DRILLER or DIGGER

ADDITIONAL DATA:

Log Water Level Measurements Chemical Analysis Aquifer Test

REMARKS:

Log: Top soil 0 to 6 ft.
Gravel 6 to 18 ft.
Cement gravel 18 to 22 ft.
Sand & gravel 22 to 25 ft.

Irrigation of 18 acres.